


NOTES:
1. SEE DRAWING 1-0101-ELYT-P002 FOR ELECTRICAL ROOM LAYOUT.

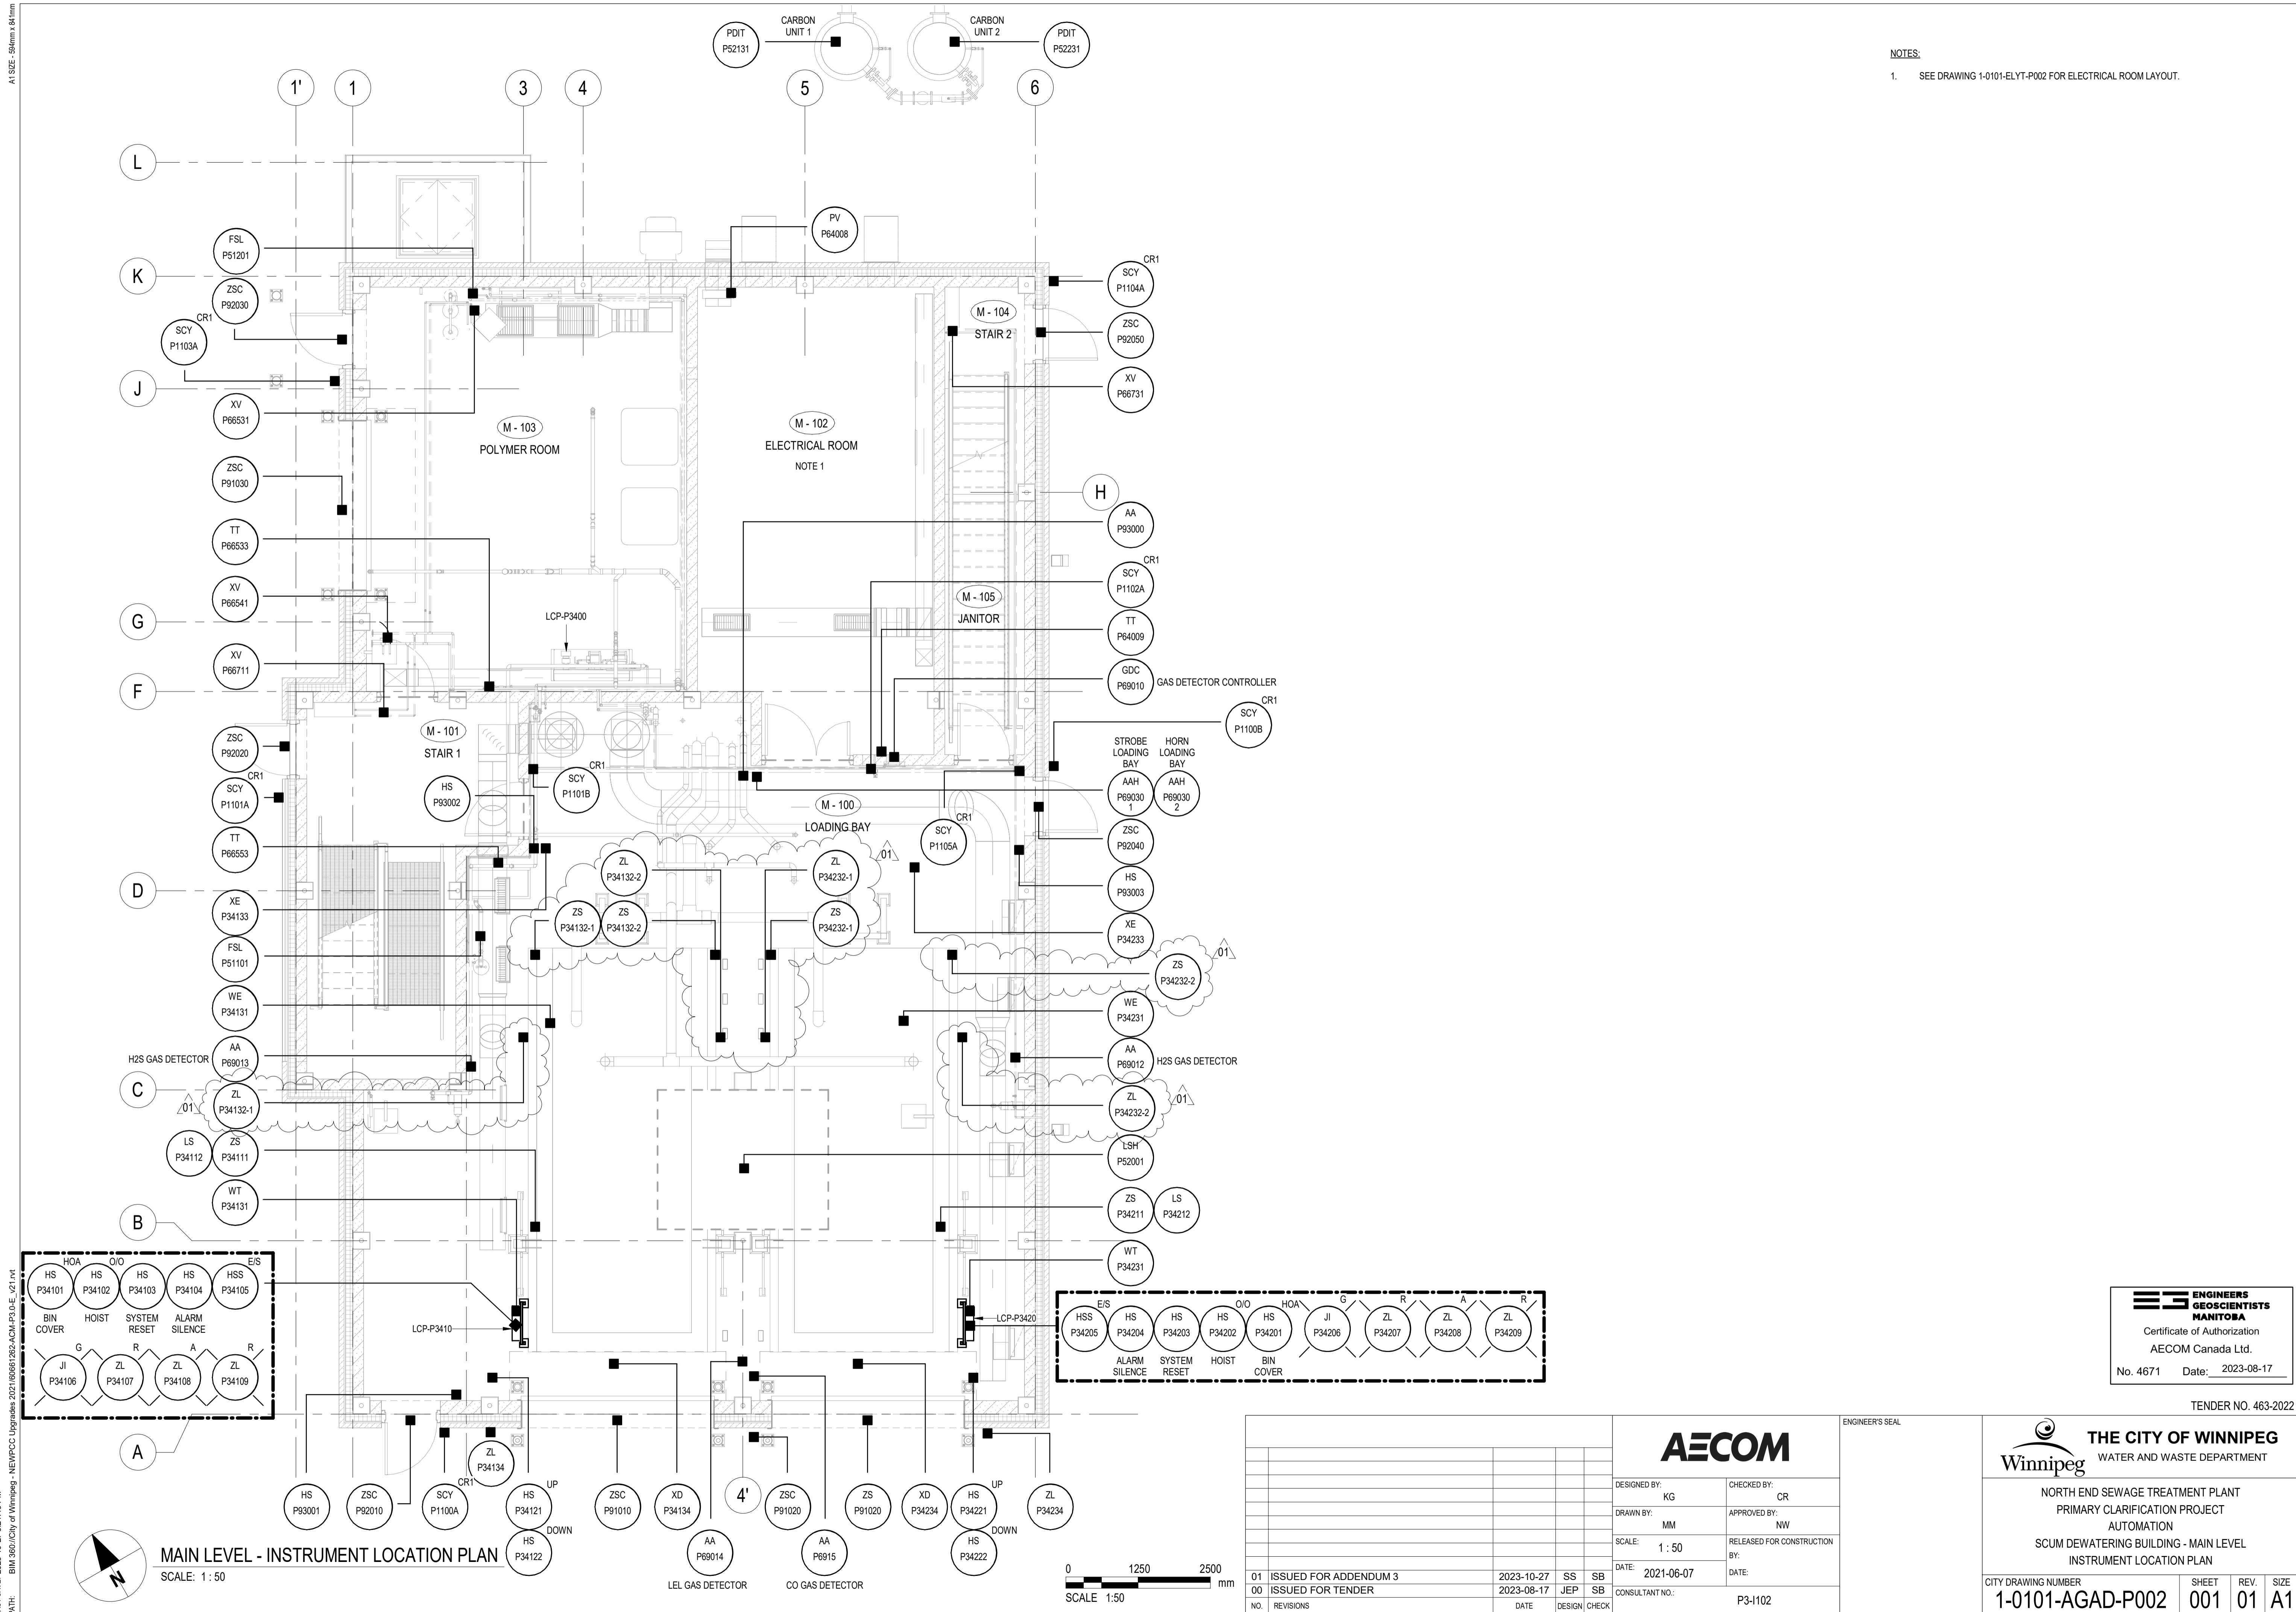

LAST SAVE: 2023-10-27 3:21:49 PM
PATH: BIM 360/City of Winnipeg - NEWPCC Upgrades 2021/66861262-ACM-P3-AE_V21.rvt

**ENGINEERS
GEOLOGISTS
MANITOBA**
Certificate of Authorization
AECOM Canada Ltd.
No. 4671 Date: 2023-08-17

TENDER NO. 463-2022

THE CITY OF WINNIPEG
WATER AND WASTE DEPARTMENT


NORTH END SEWAGE TREATMENT PLANT
PRIMARY CLARIFICATION PROJECT
AUTOMATION
SCUM DEWATERING BUILDING - MAIN LEVEL
INSTRUMENT LOCATION PLAN

CITY DRAWING NUMBER: **1-0101-AGAD-P002** SHEET: **001** REV: **01** SIZE: **A1**



DESIGNED BY: KG	CHECKED BY: CR
DRAWN BY: MM	APPROVED BY: NW
SCALE: 1:50	RELEASED FOR CONSTRUCTION BY:
DATE: 2021-06-07	DATE:
CONSULTANT NO.: P3-1102	

01	ISSUED FOR ADDENDUM 3	2023-10-27	SS	SB
00	ISSUED FOR TENDER	2023-08-17	JEP	SB
NO.	REVISIONS	DATE	DESIGN	CHECK

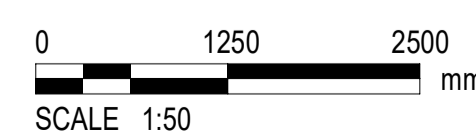

MAIN LEVEL - INSTRUMENT LOCATION PLAN
SCALE: 1:50