

TIE-POINT KEYNOTES:


SCP-09. PRIMARY SCUM FROM SCP TRANSFER PUMPS TO DIGESTERS (SEE P3-X602)

GENERAL NOTES:

1. PROVIDE A LIST AND ALLOW FOR ALL AVAILABLE DATA EXCHANGE TO THE PCS INCLUDING INPUTS, OUTPUTS, AND STATUS MONITORING.

THIS DRAWING SUPERSEDES THE FOLLOWING EXISTING DRAWINGS:

- 1-0101P-A0070-001

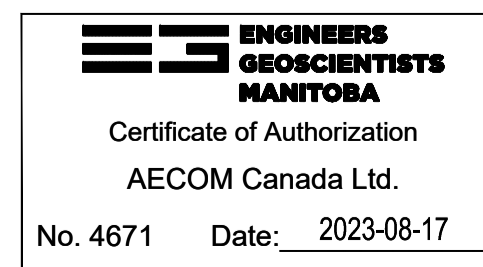

NO.	REVISIONS	DATE	DESIGN	CHECK
01	ISSUED FOR ADDENDUM 3	2023-10-27	SS	SB
00	ISSUED FOR TENDER	2023-08-17	MK	PB

AECOM	
DESIGNED BY: MK	CHECKED BY: PB
DRAWN BY: ES	APPROVED BY: NW
SCALE: NONE	RELEASED FOR CONSTRUCTION BY:
DATE: 2020-12-09	DATE:
CONSULTANT NO.: P3-X602	

ENGINEER'S SEAL

TENDER NO. 463-2022

THE CITY OF WINNIPEG
WATER AND WASTE DEPARTMENT

NORTH END SEWAGE TREATMENT PLANT
PRIMARY CLARIFICATION PROJECT
PROCESS & INSTRUMENTATION DIAGRAM
SCP TRANSFER PUMPS 1 & 2
UPGRADES

CITY DRAWING NUMBER	SHEET	REV.	SIZE
1-0101-PPID-P302	001	01	A1