A1 SIZE - 594mm x 841mm

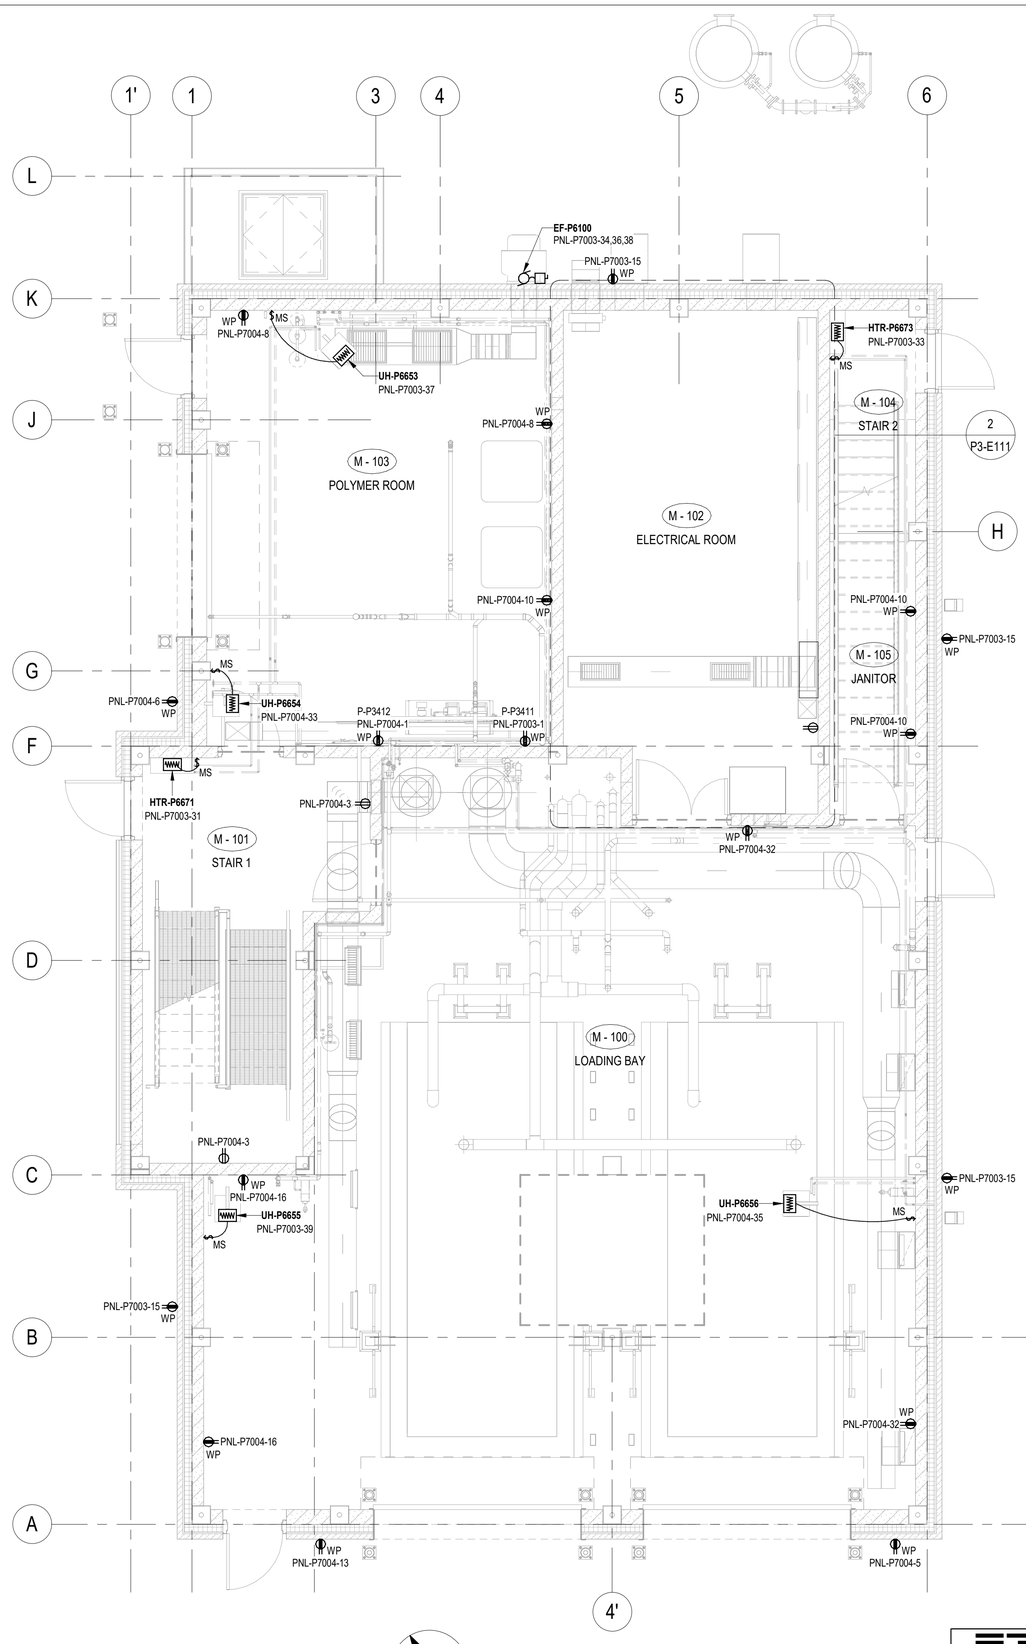

MAIN LEVEL - POWER PLAN

SCALE: 1 : 50

0 1250 2500 mm

SCALE 1:50

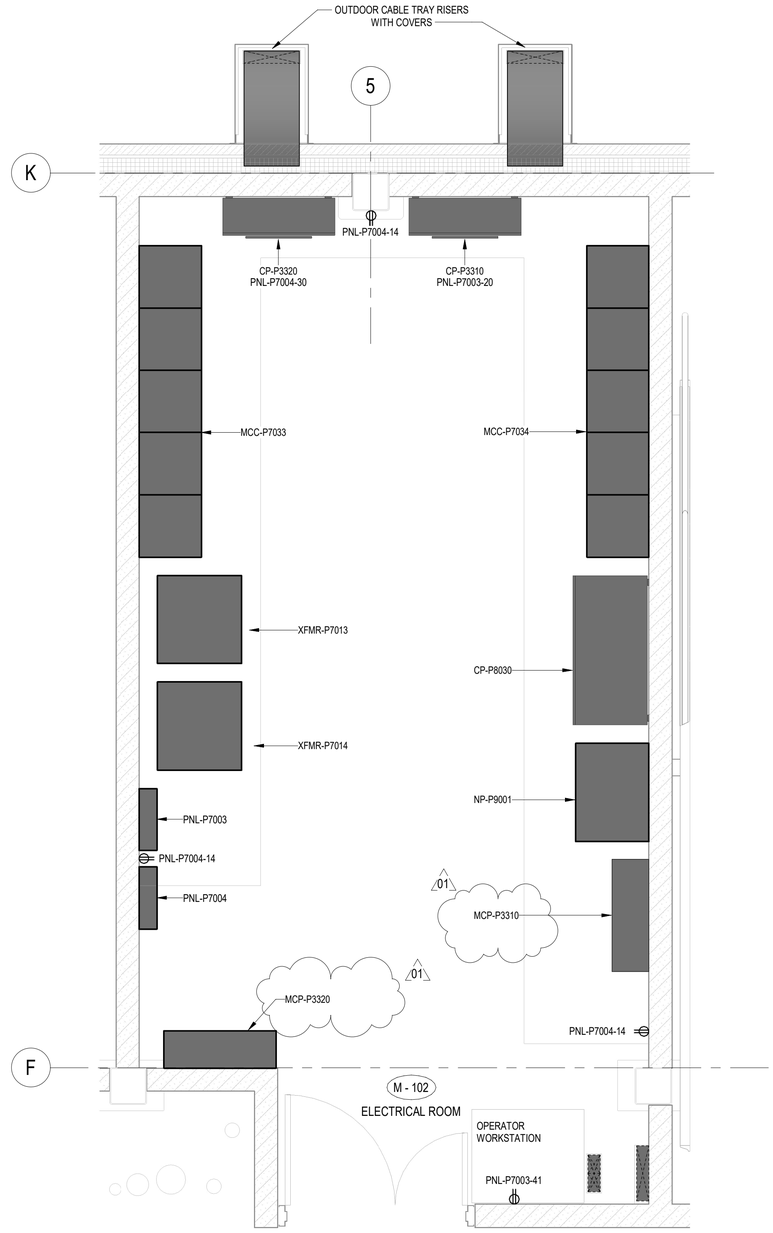

ENLARGED FLOOR PLAN - ELECTRICAL ROOM

SCALE: 1 : 25

TENDER NO. 463-2022

ENGINEERS GEOSCIENTISTS MANITOBA
Certificate of Authorization
AECOM Canada Ltd.
No. 4671 Date: 2023-08-17

NO.	REVISIONS	DATE	DESIGN	CHECK
01	ISSUED FOR ADDENDUM 5	2023-11-20	SS	SB
00	ISSUED FOR TENDER	2023-08-17	JEP	SB

AECOM

DESIGNED BY: KG	CHECKED BY: CR
DRAWN BY: TW	APPROVED BY: NW
SCALE: As indicated	RELEASED FOR CONSTRUCTION BY:
DATE: 2021-06-07	DATE:
CONSULTANT NO.: P3-E111	

ENGINEER'S SEAL
PROVINCE OF MANITOBA
G.S. BOGHOSIAN
Member
33454
REGISTERED PROFESSIONAL ENGINEER
2023-11-20

THE CITY OF WINNIPEG
WATER AND WASTE DEPARTMENT
Winnipeg

NORTH END SEWAGE TREATMENT PLANT
PRIMARY CLARIFICATION PROJECT
ELECTRICAL
SCUM DEWATERING BUILDING - MAIN LEVEL
POWER PLAN

CITY DRAWING NUMBER	SHEET	REV.	SIZE
1-0101-EGAD-P003	001	01	A1

LAST SAVE: 2023-11-20 12:27:25 PM
PATH: BIM 360://City of Winnipeg - NEWPCC Upgrades 2021/60661262-ACM-P3.0-E_v21.rvt